A0 CAD

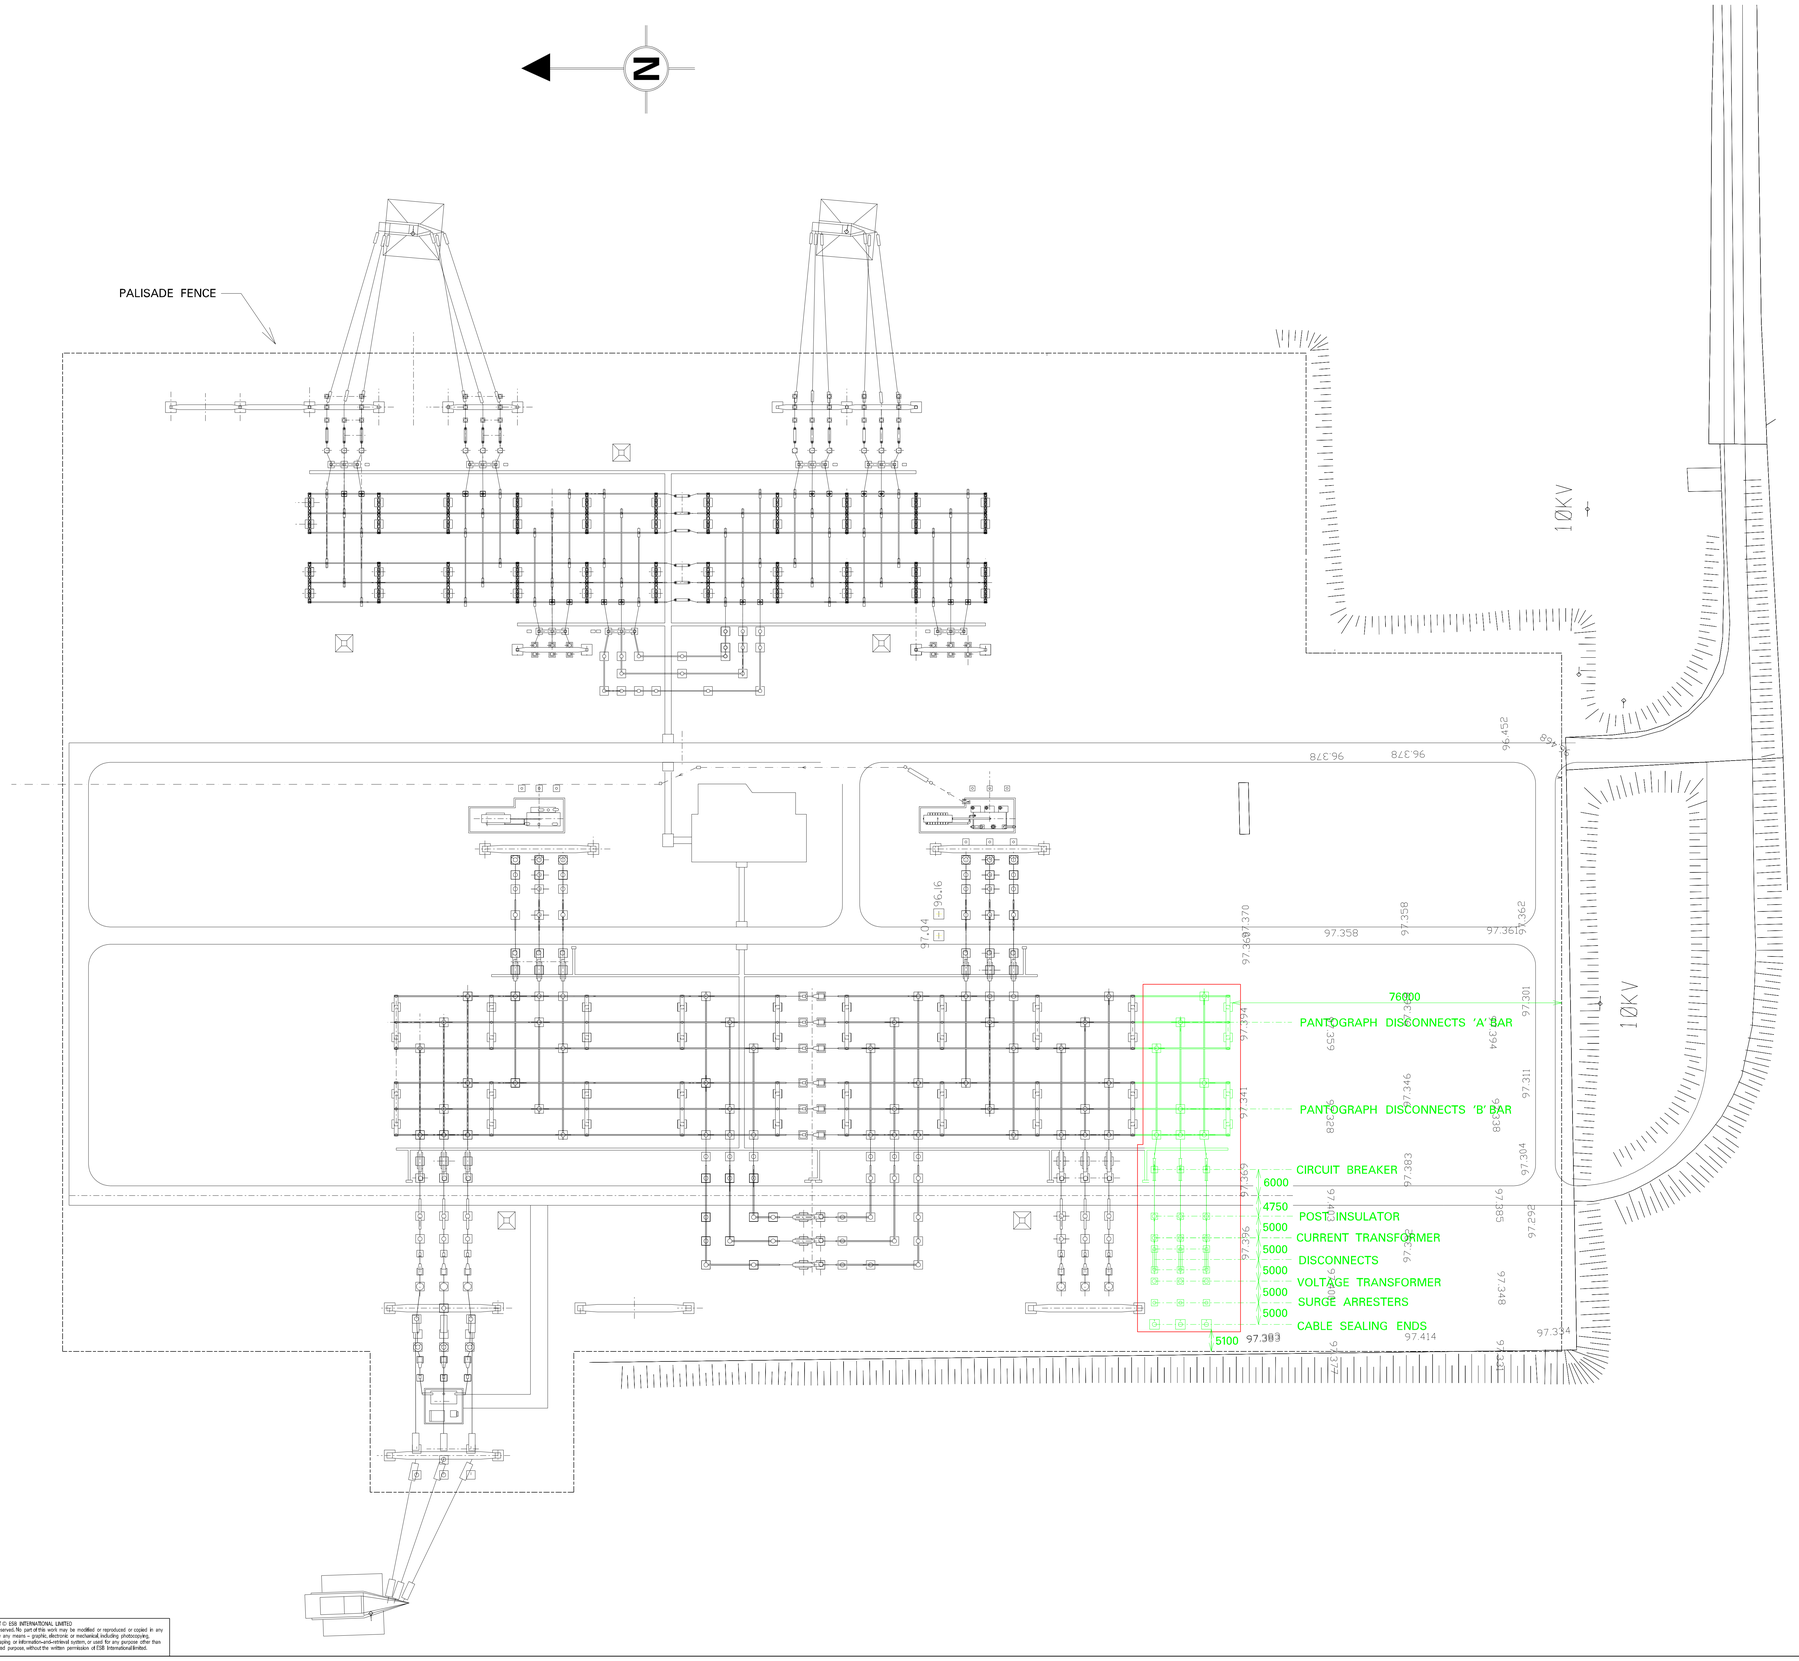

REFERENCE DRAWINGS:

PE493-D104-068-001-000	LAYOUT OF EQUIPMENT & SECTION A-A FOR PLANNING PERMISSION
PE493-D104-069-001-000	SECTION B-B FOR PLANNING PERMISSION

REV.	DATE	REVISION DESCRIPTION	DRN	PROD	VER	APP
I	11'08	PROJECT NAME CHANGED	J.W.			

PURPOSE OF ISSUE – PRELIMINARY UNLESS INDICATED

TENDER ☐ CLIENT APPROVAL ☐ CONSTRUCTION ☐ AS-BUILT ☐ REVISED ☐

Client: EIRGRID

Project: HVDC EAST WEST INTERCONNECTOR

Contract:

Drawing Title: WOODLAND 400kV STATION SITE LAYOUT FOR PLANNING PERMISSION

INSTALLATION OF BAY E5

Production Unit: High Voltage Engineering

ESB International

ESB Engineering & Facility Management Ltd
Stephen Court, 18-21 St Stephen's Green, Dublin 2 Ireland
Telephone +353-1-703 8000 Fax +353-1-661-5359
Website www.esbi.ie
Registered Office as above
Registered in Ireland No. 355249

DRAWN	PRODUCED	VERIFIED	APPROVED	APPD DATE
J.Walsh	N.Harrison	B.Leonard	C.Twomey	11/11/08

CLIENT REF	NO. OF SHTS	SIZE	SCALE
TC38490	1	A0	1:500

DRAWING NUMBER: PE493–D104–067–001–001 (SHEET – REV –)

COPYRIGHT © ESB INTERNATIONAL LIMITED
All rights reserved. No part of this work may be modified or reproduced or copied in any form or by any means – graphic, electronic or mechanical, including photocopying, recording, taping, or information-and-retrieval system, or used for any purpose other than its designated purpose, without the written permission of ESB International limited.